

AS CONSTRUCTED CERTIFICATION

I, _____ (Company's representative Name) _____ (Signature)

(Date) _____ (RPEQ)

Being a duly representative of -- _____ (Company Name)

Hereby certify that

1. The information contained in this drawing / document is in compliance with the approved drawings and design supplied under the terms of the contract.
2. This represents an accurate "As constructed" record of works carried out and accept responsibility for the information contained in this drawing / document.

I, _____
(Company's representative Name) _____ (Signature) _____

(Date) _____ (RFD) _____
Being a duly representative of - _____

(Company Name)

Hereby certify that

1. The information contained in this drawing / document is in compliance with the approved drawings and design supplied under the terms of the contract.

2. This represents an accurate "As constructed" record of works carried out and accept responsibility for the information contained in this drawing / document.

Hereby certify that

1. The information contained in this drawing / document is in compliance with the approved drawings and design supplied under the terms of the contract.
2. This represents an accurate "As constructed" record of works carried out and accept responsibility for the information contained in this drawing / document.



0 20 40 60 80 100m
SCALE 1:1000 @A1

AS-CONSTRUCTED

REGISTERED SURVEYOR'S CERTIFICATION

I, Dale Delaforce, hereby certify that the vertical and horizontal locations and dimensions shown on this plan are a true and correct record and were located by survey.



Registered Surveyor (sig.) Reg. Surveyor No. 6176 Date: 31/08/2026

I, Dale Delaforce, hereby certify that the vertical and horizontal locations and dimensions shown on this plan are a true and correct record and were located by survey.


Registered Surveyor [sig] Reg. Surveyor No. 6176 Date: 31/08/2026

COORDINATE DATUM :-
HORIZONTAL COORDINATES (E,N) SUPPLIED ARE MAPPING
GRID OF AUSTRALIA (MGA), ZONE 56 BASED ON THE
UNIVERSAL TRANSVERSE MERCATOR PROJECTION AND THE
GEOCENTRIC DATUM OF AUSTRALIA 2020

A1

[illegible]

AS CONSTRUCTED SURVEY - STORMWATER
HIGHLAND WALLOON
STAGE 2
213 TAYLORS ROAD, WALLOON, QLD

SHEET 1 OF 4	SHEETS	SCALE	1:1000
REVISION DATE	31/08/2026	REVISION	A
DISCIPLINE CODE	-		
DRAWING NO.			
ICC-2574-2-SW-01			

AS CONSTRUCTED CERTIFICATION

I, _____ (Company's representative Name) _____ (Signature)

(Date) _____ (RPED)

Being a duly representative of -- _____ (Company Name)

Hereby certify that

1. The information contained in this drawing / document is in compliance with the approved drawings and design supplied under the terms of the contract.
2. This represents an accurate "As constructed" record of works carried out and accept responsibility for the information contained in this drawing / document.

I, _____
(Company's representative Name) _____ (Signature) _____

(Date) _____ (RFD) _____
Being a duly representative of - _____


(Company Name)

Hereby certify that

1. The information contained in this drawing / document is in compliance with the approved drawings and design supplied under the terms of the contract.
2. This represents an accurate "As constructed" record of works carried out and accept responsibility for the information contained in this drawing / document.

Hereby certify that

1. The information contained in this drawing / document is in compliance with the approved drawings and design supplied under the terms of the contract.
2. This represents an accurate "As constructed" record of works carried out and accept responsibility for the information contained in this drawing / document.

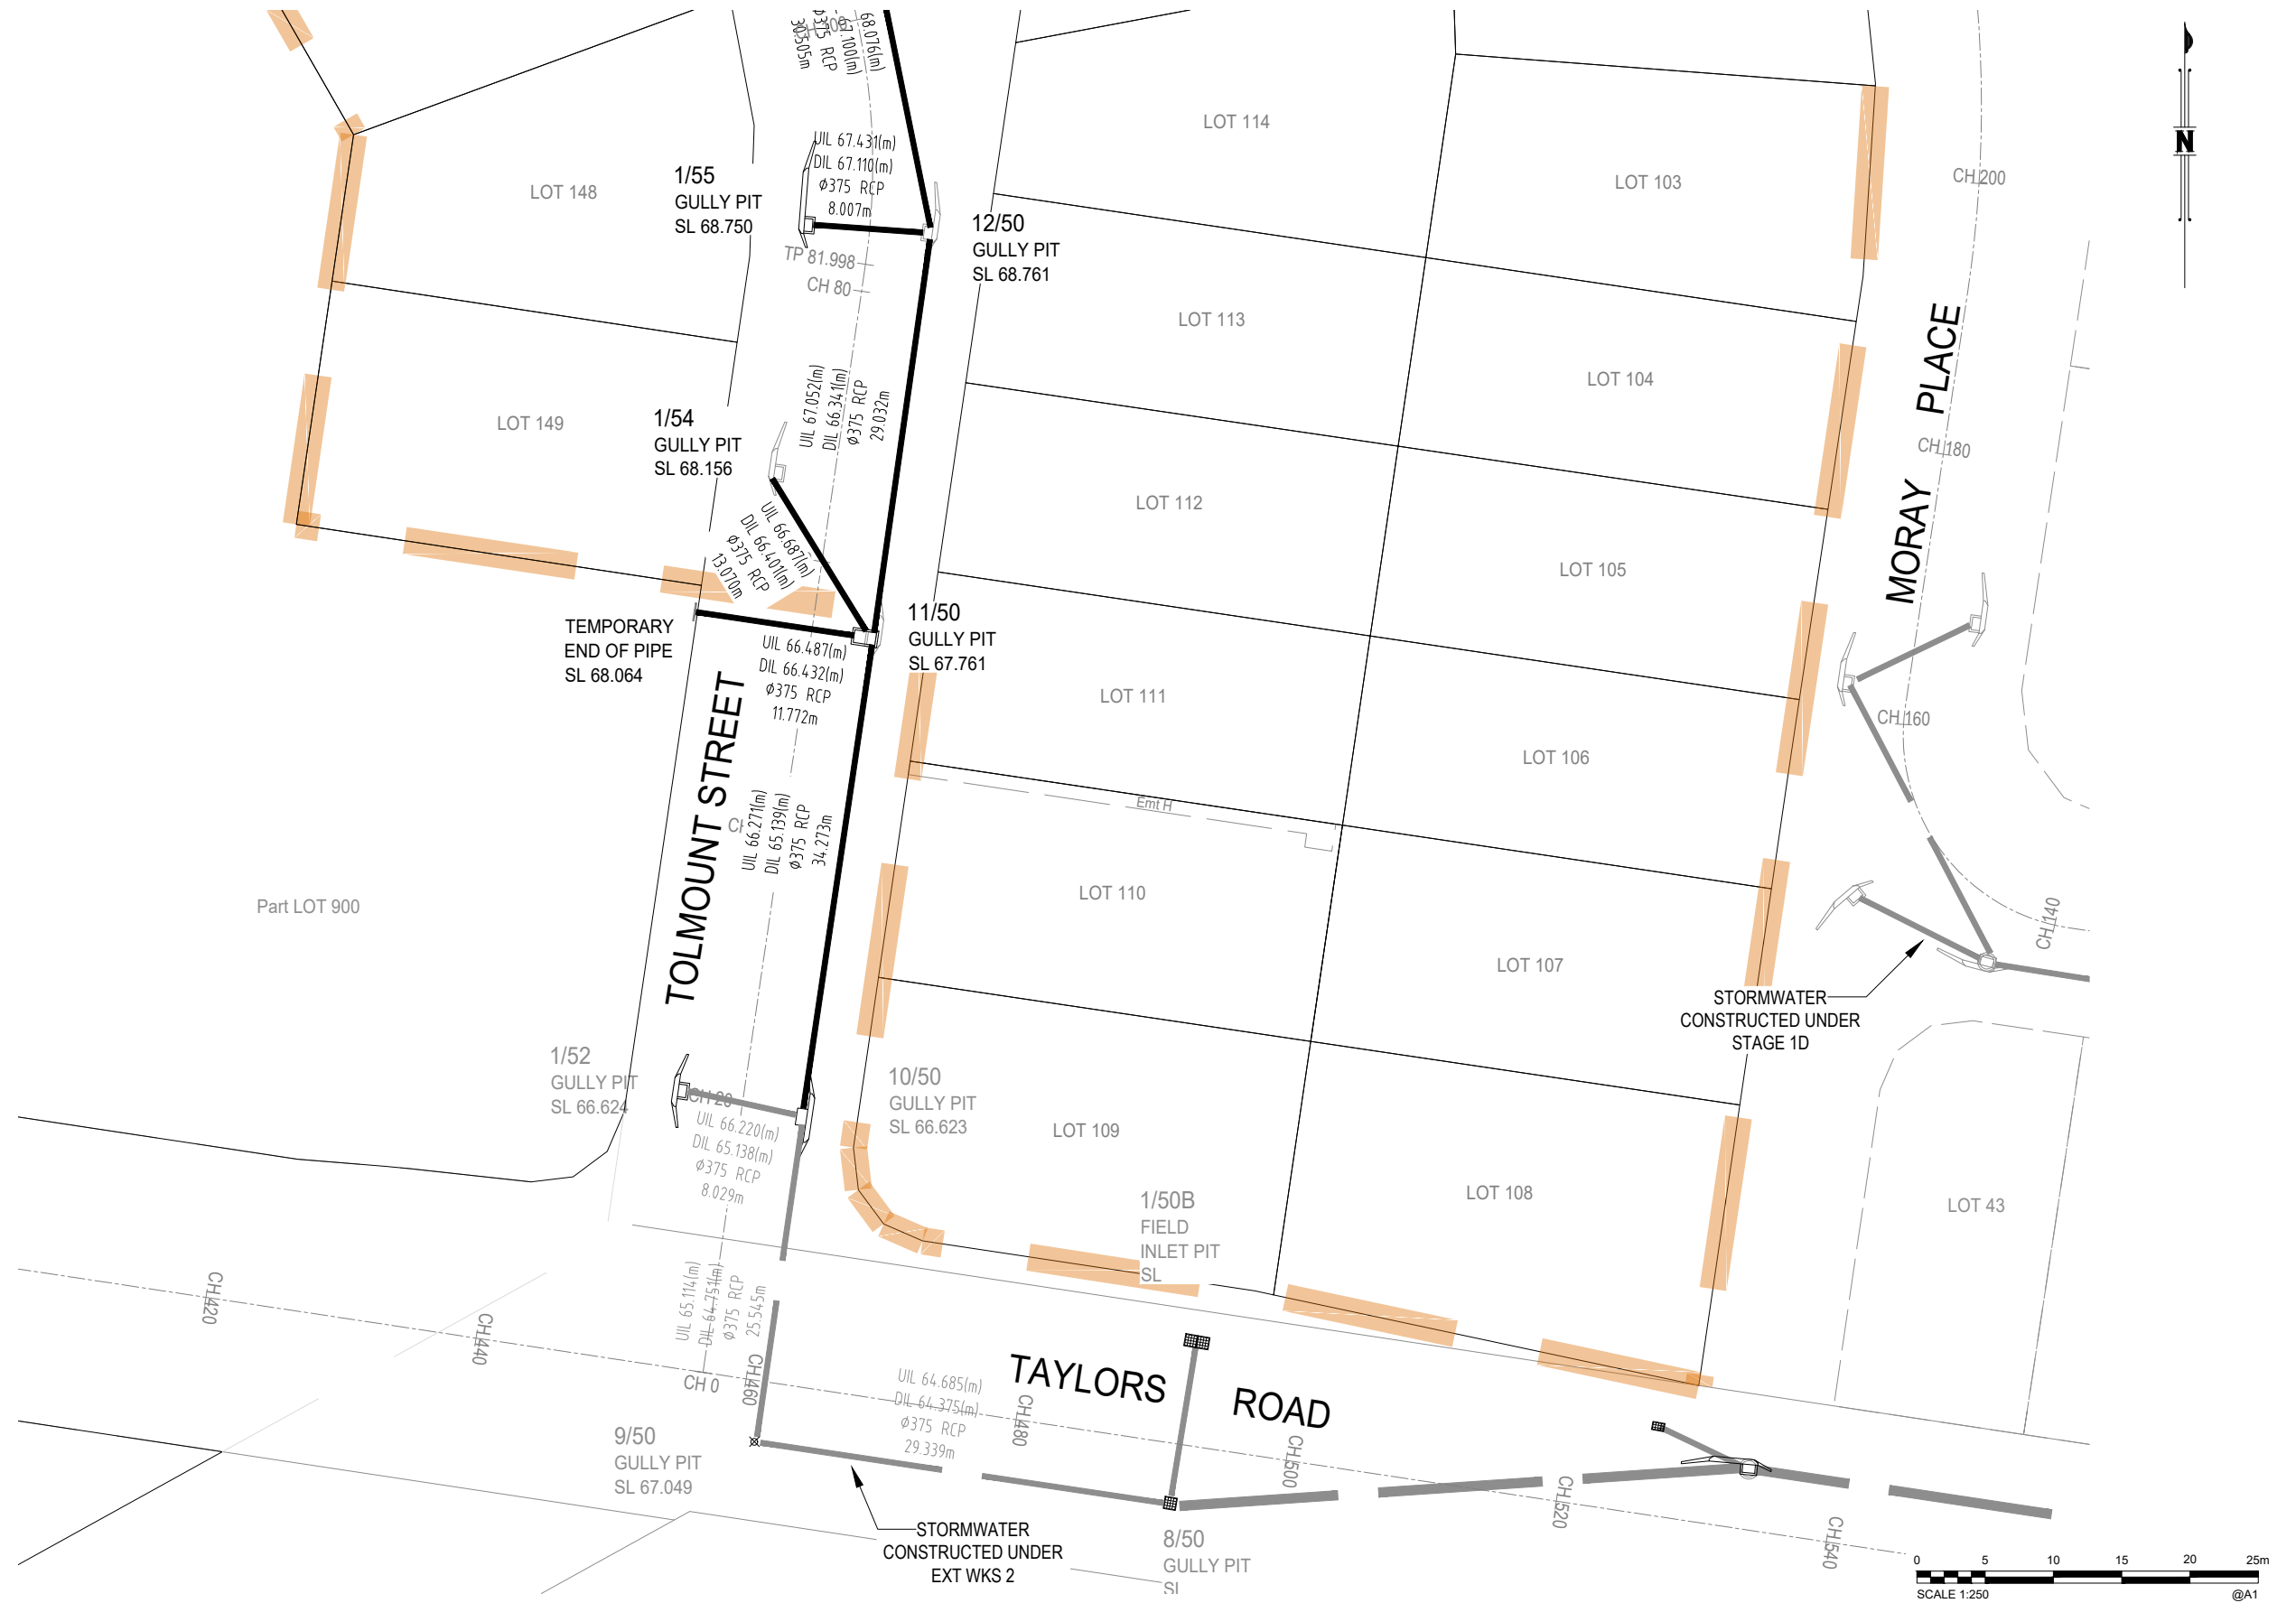

REGISTERED SURVEYOR'S CERTIFICATION

I, Dale DeLaforce, hereby certify that the vertical and horizontal locations and dimensions shown on this plan are a true and correct record and were located by survey.

Registered Surveyor (sig.) Reg. Surveyor No. 6176 Date: 31/08/2026

I, Dale Delaforce, hereby certify that the vertical and horizontal locations and dimensions shown on this plan are a true and correct record and were located by survey.


Registered Surveyor (sig.) Reg. Surveyor No. 6176 Date: 31/08/2026

COORDINATE DATUM :-
HORIZONTAL COORDINATES (E,N) SUPPLIED ARE MAPPING
GRID OF AUSTRALIA (MGA), ZONE 56 BASED ON THE
UNIVERSAL TRANSVERSE MERCATOR PROJECTION AND THE
GEOCENTRIC DATUM OF AUSTRALIA 2020

AS-CONSTRUCTED

A1

[illegible]

Ipswich City Council

AS CONSTRUCTED SURVEY - STORMWATER
HIGHLAND WALLOON
STAGE 2
213 TAYLORS ROAD, WALLOON, QLD

SHEET 2 OF 4		SHEETS	SCALE 1:250
REVISION DATE	31/08/2026		REVISION A
DISCIPLINE CODE	—		
DRAWING NO.			
ICC-2574-2-SW-02			

AS CONSTRUCTED CERTIFICATION

I, _____ (Company's representative Name) _____ (Signature)

(Date) _____ (RPEQ)

Being a duly representative of -- _____ (Company Name)

Hereby certify that

1. The information contained in this drawing / document is in compliance with the approved drawings and design supplied under the terms of the contract.
2. This represents an accurate "As constructed" record of works carried out and accept responsibility for the information contained in this drawing / document.

I, _____
(Company's representative Name) _____ (Signature) _____

(Date) _____ (RPEO) _____
Being a duly representative of :- _____

(Company Name)

Herely certify that

1. The information contained in this drawing / document is in compliance with the approved drawings and design supplied under the terms of the contract.
2. This represents an accurate "As constructed" record of works carried out and accept responsibility for the information contained in this drawing / document.

Hereby certify that

1. The information contained in this drawing / document is in compliance with the approved drawings and design supplied under the terms of the contract.
2. This represents an accurate "As constructed" record of works carried out and accept responsibility for the information contained in this drawing / document.



REGISTERED SURVEYOR'S CERTIFICATION

I, Dale DeLaforce , hereby certify that the vertical and horizontal locations and dimensions shown on this plan are a true and correct record and were located by survey.

Registered Surveyor (sig) Reg. Surveyor No. 6176 Date: 31/08/2026

I, Dale Delaforce, hereby certify that the vertical and horizontal locations and dimensions shown on this plan are a true and correct record and were located by survey.

Registered Surveyor (sig.) Reg. Surveyor No. 6176 Date: 31/08/2026

COORDINATE DATUM :-
HORIZONTAL COORDINATES (E,N) SUPPLIED ARE MAPPING
GRID OF AUSTRALIA (MGA), ZONE 56 BASED ON THE
UNIVERSAL TRANSVERSE MERCATOR PROJECTION AND THE
GEOCENTRIC DATUM OF AUSTRALIA 2020

HORIZONTAL COORDINATES (E,N) SUPPLIED ARE MAPPING GRID OF AUSTRALIA (MGA), ZONE 56 BASED ON THE UNIVERSAL TRANSVERSE MERCATOR PROJECTION AND THE GEOCENTRIC DATUM OF AUSTRALIA 2020

AS-CONSTRUCTED

[illegible]

DRAWN	RW	31/08/2026
CHECKED	DAM	31/08/2026
PASSED		
	INITIALS	DATE



AS CONSTRUCTED SURVEY - STORMWATER
HIGHLAND WALLOON
STAGE 2
213 TAYLORS ROAD, WALLOON, QLD

DISCIPLINE CODE	-
DRAWING NO.	ICC-2574-2-SW-03

AS CONSTRUCTED CERTIFICATION

I, _____ (Company's representative Name) _____ (Signature)

(Date) _____ (RPED)

Being a duly representative of -- _____ (Company Name)

Hereby certify that

1. The information contained in this drawing / document is in compliance with the approved drawings and design supplied under the terms of the contract.
2. This represents an accurate "As constructed" record of works carried out and accept responsibility for the information contained in this drawing / document.

I, _____
 (Company's representative Name) (Signature)

 (Date) (RPEQ)
 Being a duly representative of :- _____
 (Company Name)
 Hereby certify that
 1. The information contained in this drawing / document is in compliance with the approved drawings and design supplied under the terms of the contract.
 2. This represents an accurate "As constructed" record of works carried out and accept responsibility for the information contained in this drawing / document.

Hereby certify that

1. The information contained in this drawing / document is in compliance with the approved drawings and design supplied under the terms of the contract.
2. This represents an accurate "As constructed" record of works carried out and accept responsibility for the information contained in this drawing / document.



REGISTERED SURVEYOR'S CERTIFICATION

I, Dale Delaforce, hereby certify that the vertical and horizontal locations and dimensions shown on this plan are a true and correct record and were located by survey.

Registered Surveyor (sig) Reg. Surveyor No. 6176 Date: 31/08/2026

I, Dale Delaforce, hereby certify that the vertical and horizontal locations and dimensions shown on this plan are a true and correct record and were located by survey.


Registered Surveyor (sig.) Reg. Surveyor No. 6176 Date: 31/08/2026

COORDINATE DATUM :-
HORIZONTAL COORDINATES (E,N) SUPPLIED ARE MAPPING
GRID OF AUSTRALIA (MGA), ZONE 56 BASED ON THE
UNIVERSAL TRANSVERSE MERCATOR PROJECTION AND THE
GEOCENTRIC DATUM OF AUSTRALIA 2020

0 5 10 15 20 25m
SCALE 1:250 @A1

AS-CONSTRUCTED

A1

[illegible]

Ipswich City Council

AS CONSTRUCTED SURVEY - STORMWATER
HIGHLAND WALLOON
STAGE 2
213 TAYLORS ROAD, WALLOON, QLD

SHEET 4 OF 4 SHEETS	SCALE 1:250
---------------------	-------------

REVISION DATE	31/08/2026	REVISION	A
---------------	------------	----------	---

DISCIPLINE CODE	—
-----------------	---

DRAWING NO.
ICC-2574-2-SW-04